


- GENERAL NOTES:**
1. NOT USED.
  2. VERIFY EXISTING DIMENSIONS ON SITE PRIOR TO FABRICATION OR INSTALLATION OF NEW WORK.
  3. HIGH PRESSURE WATER BLAST EXISTING FACE BRICK TO REMAIN EXPOSED AND MAKE GOOD AS PER SPECIFICATION SECTION 04813 MASONRY VENEER.
  4. ALL EXISTING CMU TO REMAIN ON WEST FACADE TO RECEIVE A PARGING COAT AS PER DETAIL 2/A2407.
  5. APPLY WATER REPELLANT TO EXTERIOR BRICK AND CAST STONE.
  6. COORDINATE SIZE AND LOCATION OF PENETRATIONS WITH EQUIPMENT SUPPLIER.
  7. REFER TO STRUCTURAL DRAWINGS FOR CMU CONTROL JOINT LOCATIONS.
  8. BLOCK FILLER AND PAINT TO ALL NEW CMU. SEE SPECIFICATIONS.

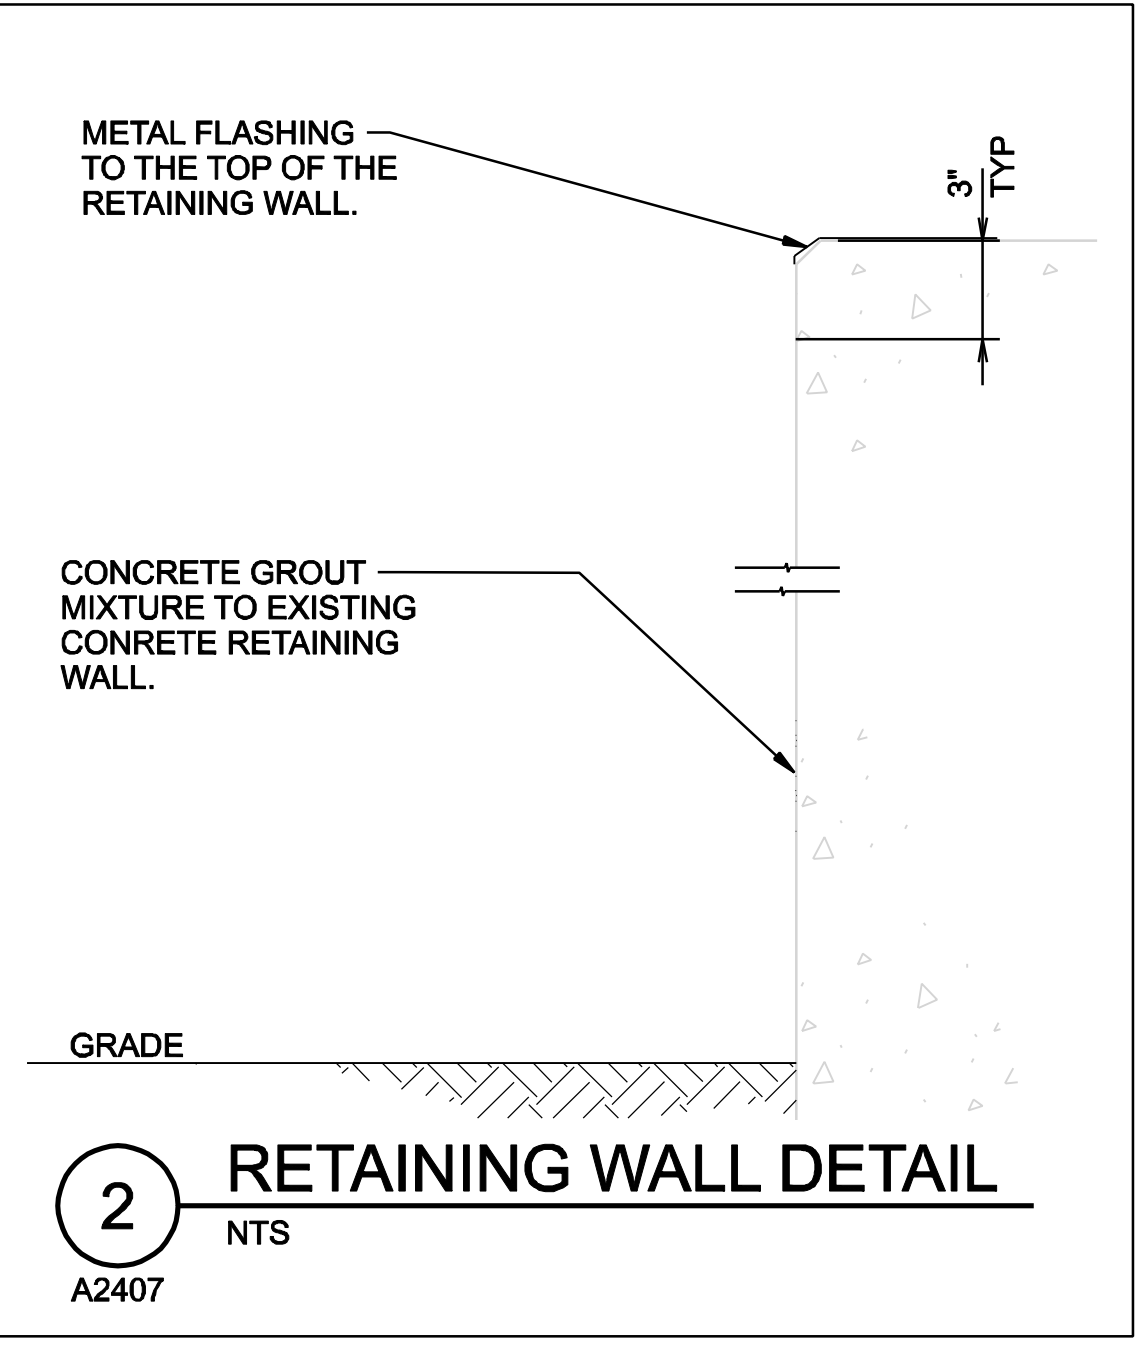

**1 WEST ELEVATION**  
1/4"=1'-0"  
A2407

THESE RECORD DOCUMENTS HAVE BEEN PREPARED BASED ON THE INFORMATION PROVIDED BY OTHERS. THE DESIGN PROFESSIONAL HAS NOT VERIFIED THE ACCURACY AND/OR COMPLETENESS OF THIS INFORMATION AND SHALL NOT BE RESPONSIBLE FOR ANY ERRORS OR OMISSIONS WHICH MAY BE INCORPORATED HEREIN AS A RESULT.

<b>STAMFORD WPC</b> STAMFORD WATER POLLUTION CONTROL AUTHORITY SOLIDS DRYING PROJECT		01/20/08	DR	WYU	APVD
		09/08/06	CHK	WYU	LGRANDE
07/04/06	BY	BY	BY	BY	BY
06/05/06	NO.	NO.	NO.	NO.	NO.
DATE	REVISION	REVISION	REVISION	REVISION	REVISION
RECORD DRAWING RE-ISSUED FOR CONSTRUCTION ISSUED FOR CONSTRUCTION FOR FINAL REVIEW/ BUILDING PERMIT					
CH2MHILL ARCHITECTURAL WEST ELEVATION					
VERIFY SCALE BAR IS ONE INCH ON ORIGINAL DRAWING.					
DATE	JUNE 2006				
PROJ	334058				
DWG	A-2407				
SHEET	A10				