


1 2 3 4 5 6

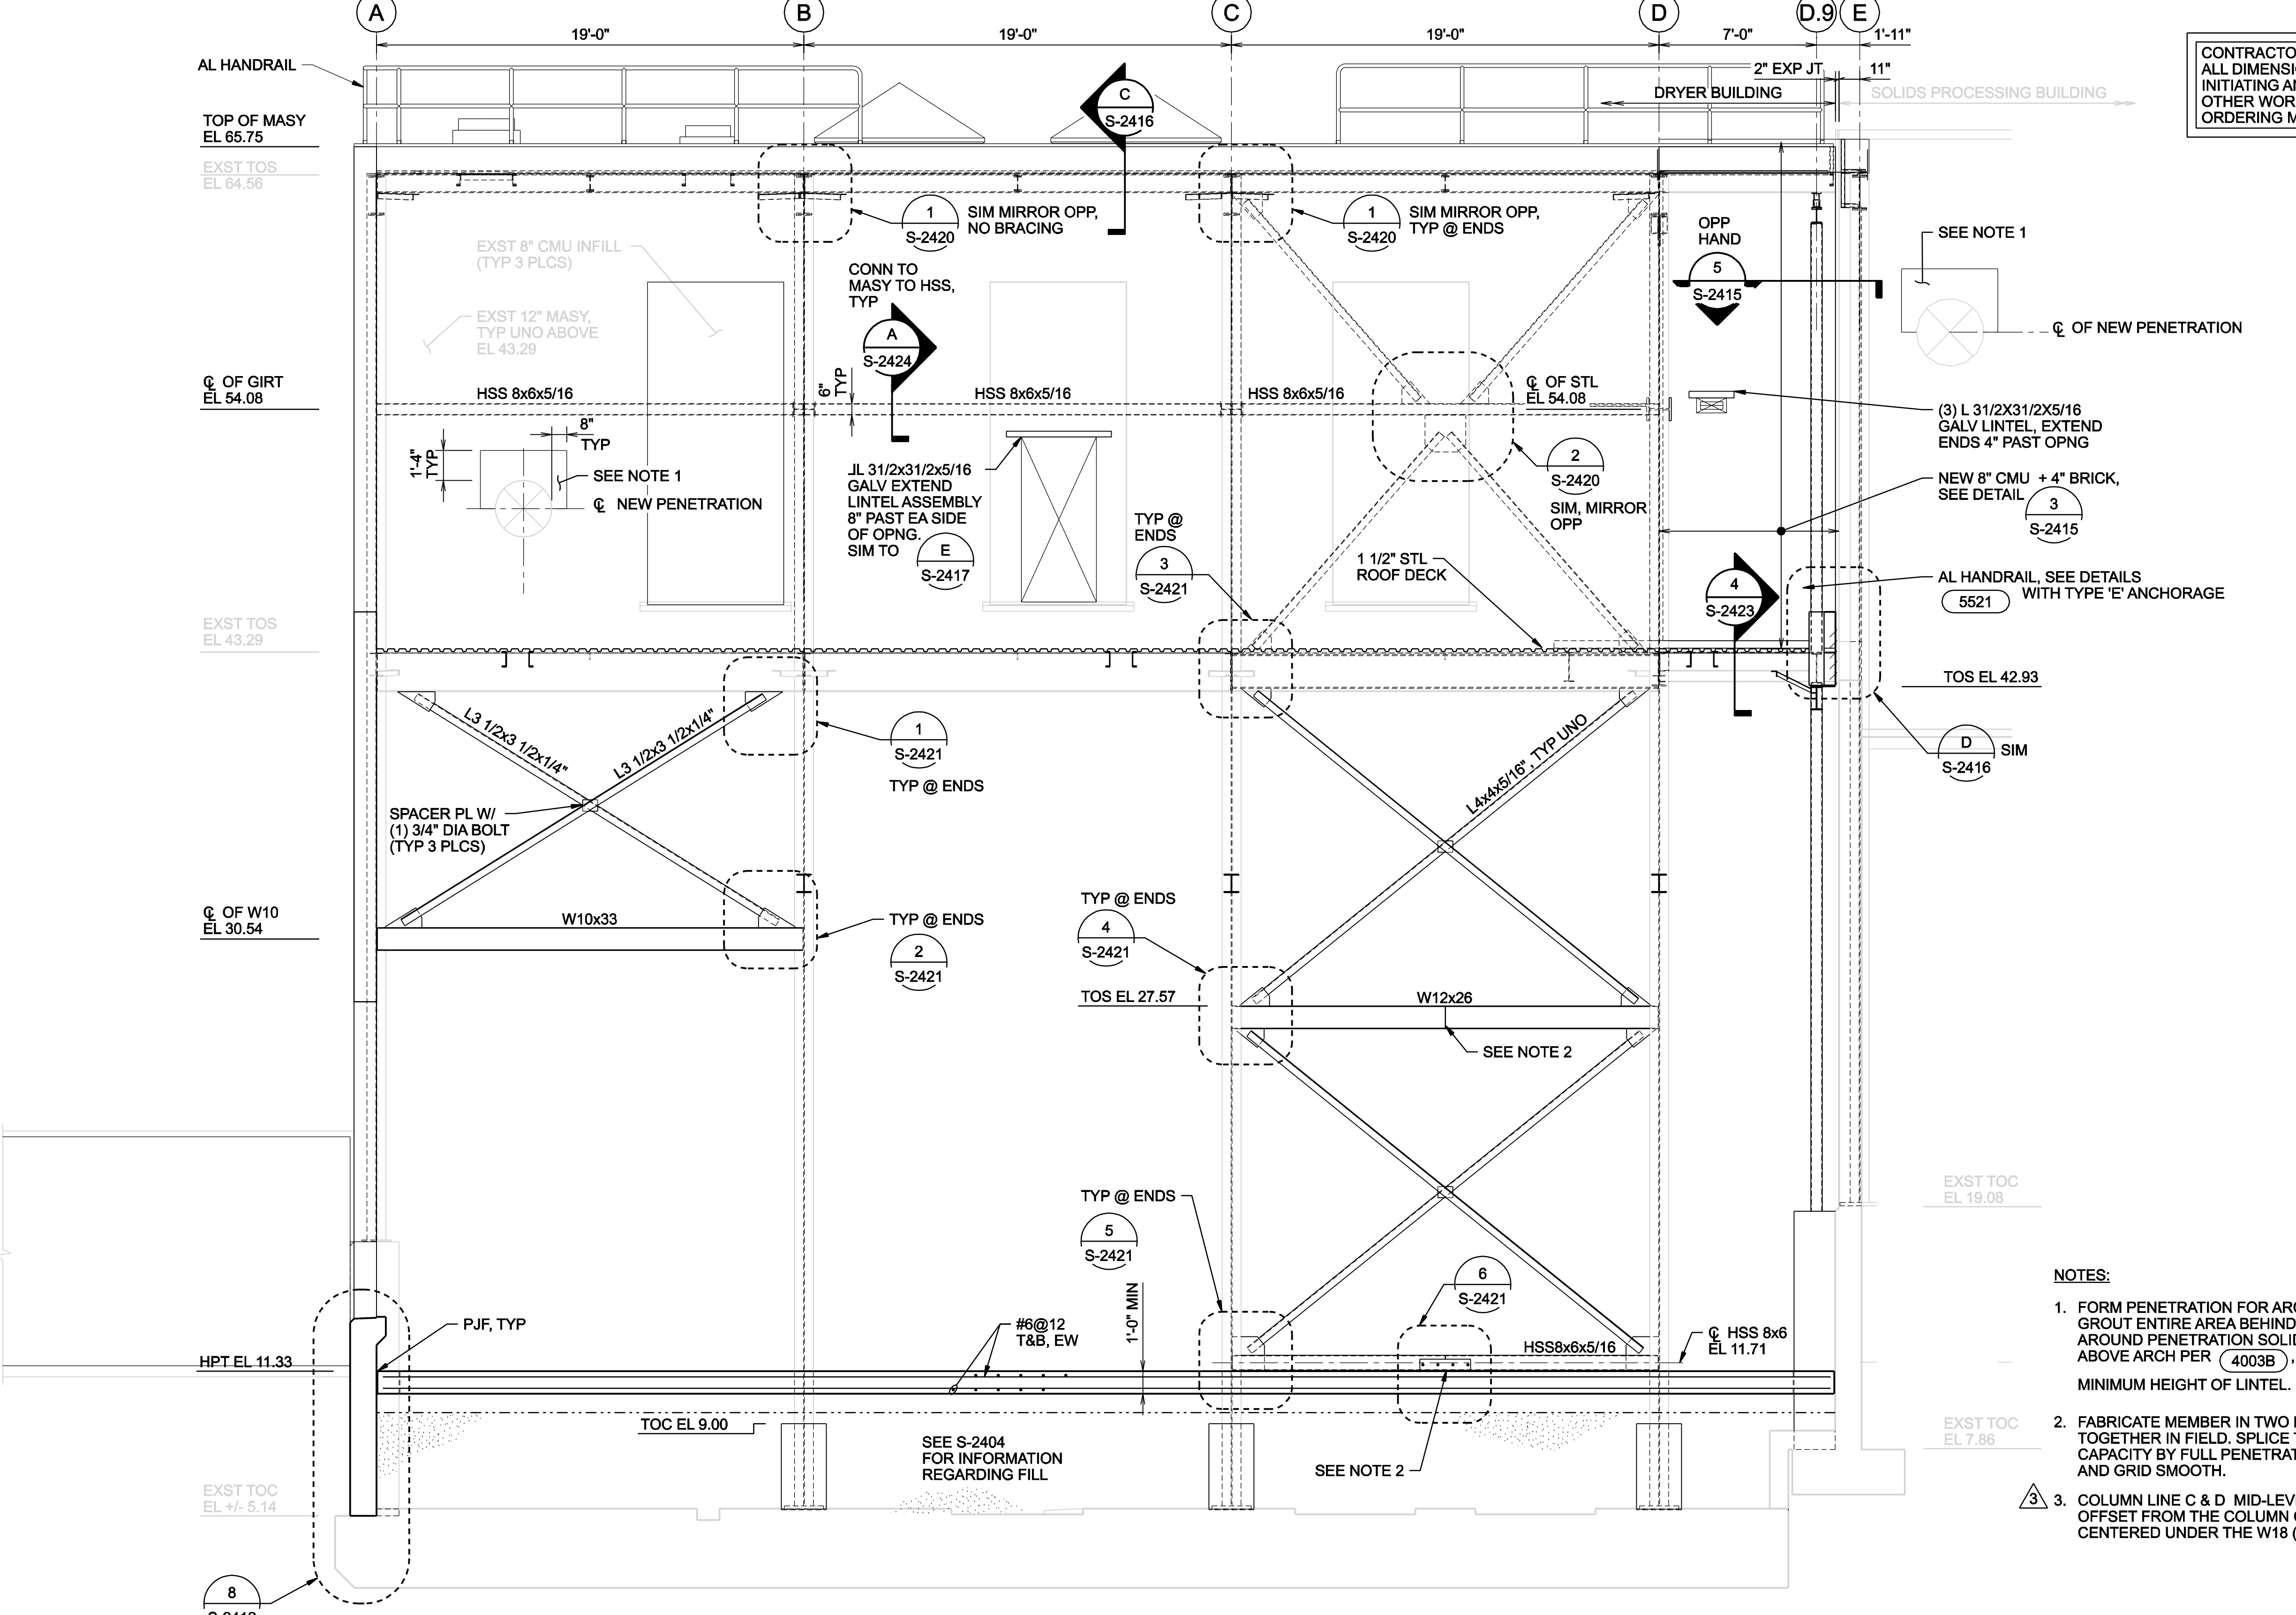

CONTRACTOR TO FIELD VERIFY ALL DIMENSIONS PRIOR TO INITIATING ANY DEMOLITION OR OTHER WORK INCLUDING ORDERING MATERIALS.

- NOTES:**
- FORM PENETRATION FOR ARCHED CONSTRUCTION. GROUT ENTIRE AREA BEHIND BRICK WYTHE AND AROUND PENETRATION SOLID. REINFORCE AREA ABOVE ARCH PER (4003B), EXCEPT USE 16" MINIMUM HEIGHT OF LINTEL.
 - FABRICATE MEMBER IN TWO PIECES. SPLICE PIECES TOGETHER IN FIELD. SPLICE TO DEVELOP FULL CAPACITY BY FULL PENETRATION WELD ALL AROUND AND GRID SMOOTH.
 - COLUMN LINE C & D MID-LEVEL W12 AND HSS 8x8 OFFSET FROM THE COLUMN CENTERLINE AND CENTERED UNDER THE W18 (SEE SECTION D/S-2406).

J SECTION
1/4"=1'-0"
S-2400, S-2401
S-2402

THESE RECORD DOCUMENTS HAVE BEEN PREPARED BASED ON THE INFORMATION PROVIDED BY OTHERS. THE DESIGN PROFESSIONAL HAS NOT VERIFIED THE ACCURACY AND/OR COMPLETENESS OF THIS INFORMATION AND SHALL NOT BE RESPONSIBLE FOR ANY ERRORS OR OMISSIONS WHICH MAY BE INCORPORATED HEREIN AS A RESULT.

RECORD DRAWING RFI DR-9		REVISION		APVD	
RE-ISSUED FOR CONSTRUCTION	ISSUED FOR CONSTRUCTION	BY	MC	BY	APVD
FOR FINAL REVIEW/ BUILDING PERMIT		NO.	DATE	DR	CHK
4	01/20/08	3	09/29/06	M. CHYZANOWSKI	B. GACKSTATTER
2	09/08/06	1	07/04/06	G. OMORI	M. GOODSON
1	06/19/06	0			
STAMFORD WPC		STAMFORD WATER POLLUTION CONTROL AUTHORITY		SOLIDS DRYING PROJECT	
STRUCTURAL SECTION		VERIFY SCALE		DATE JUNE 2006	
		BAR IS ONE INCH ON ORIGINAL DRAWING.		PROJ 334058	
		DATE		DWG S-2410	
		SHEET		S23	