


1 2 3 4 5 6

A
B
C
D

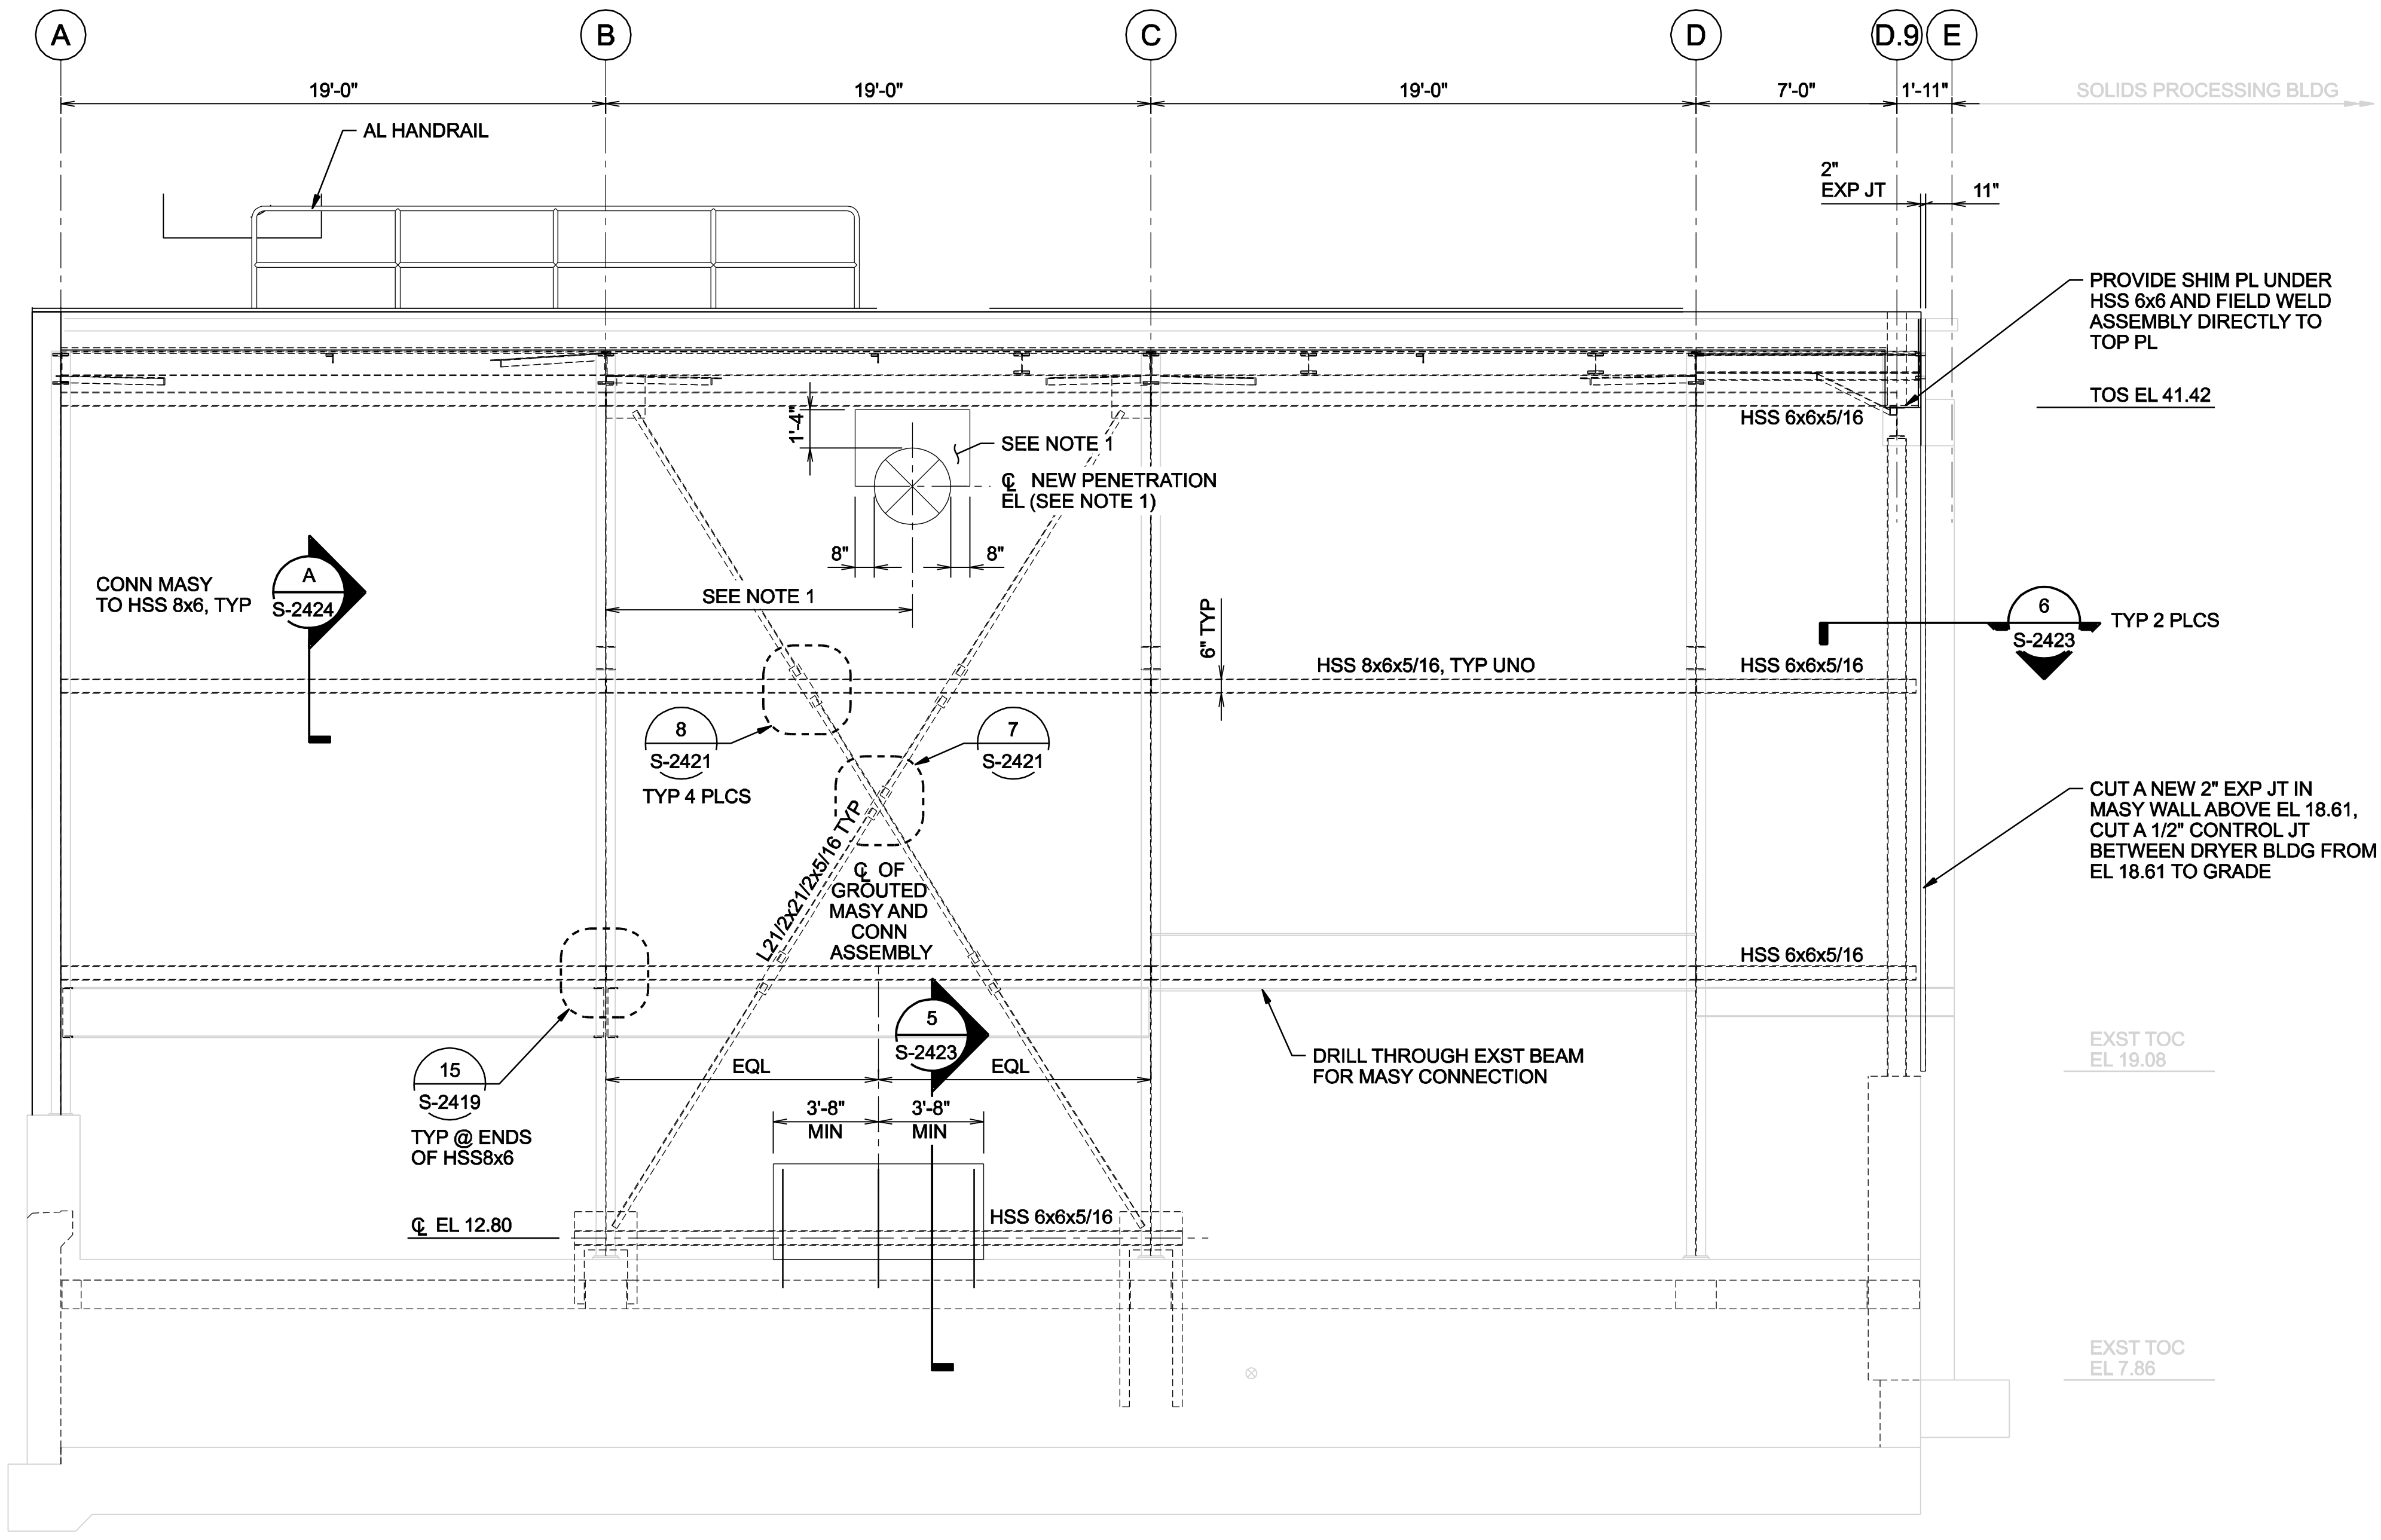

TOP OF MASY EL 45.08
TOS EL 43.44
C OF GIRT EL 41.77

C OF GIRT EL 32.04

C OF GIRT EL 22.04

EXST TOC EL 17.08

EXST TOC EL 12.04

EXST TOC EL +/- 4.92

SOLIDS PROCESSING BLDG

TOS EL 41.42

EXST TOC EL 19.08

EXST TOC EL 7.86

(K) SECTION
1/4"=1'-0"
S-2400, S-2401

CONTRACTOR TO FIELD VERIFY ALL DIMENSIONS PRIOR TO INITIATING ANY DEMOLITION OR OTHER WORK INCLUDING ORDERING MATERIALS.

NOTE:
1. FORM PENETRATION FOR ARCHED CONSTRUCTION. GROUT ENTIRE AREA BEHIND BRICK WYTHE AND AROUND PENETRATION SOLID. REINFORCE AREA ABOVE ARCH PER (4003B). EXCEPT USE 16" MINIMUM HEIGHT OF LINTEL.

THESE RECORD DOCUMENTS HAVE BEEN PREPARED BASED ON THE INFORMATION PROVIDED BY OTHERS. THE DESIGN PROFESSIONAL HAS NOT VERIFIED THE ACCURACY AND/OR COMPLETENESS OF THIS INFORMATION AND SHALL NOT BE RESPONSIBLE FOR ANY ERRORS OR OMISSIONS WHICH MAY BE INCORPORATED HEREIN AS A RESULT.

RECORD DRAWING	RE-ISSUED FOR CONSTRUCTION	ISSUED FOR CONSTRUCTION	FOR FINAL REVIEW/ BUILDING PERMIT
NO.	DATE	NO.	DATE
3	01/20/08	2	09/08/06
2	07/04/06	1	07/04/06
1	06/19/06	0	06/19/06
DGN		DR	
M. CHRZANOWSKI		G. OMORI	
M. GOODSON		B. GACKSTATTER	
BY		BY	
APVD	APVD	APVD	APVD



STAMFORD WATER POLLUTION CONTROL AUTHORITY
SOLIDS DRYING PROJECT

CH2MHILL

STRUCTURAL SECTION

VERIFY SCALE	
BAR IS ONE INCH ON ORIGINAL DRAWING.	
DATE	JUNE 2006
PROJ	334058
DWG	S-2411
SHEET	S24