


CONTRACTOR TO FIELD VERIFY ALL DIMENSIONS PRIOR TO INITIATING ANY DEMOLITION OR OTHER WORK INCLUDING ORDERING MATERIALS.

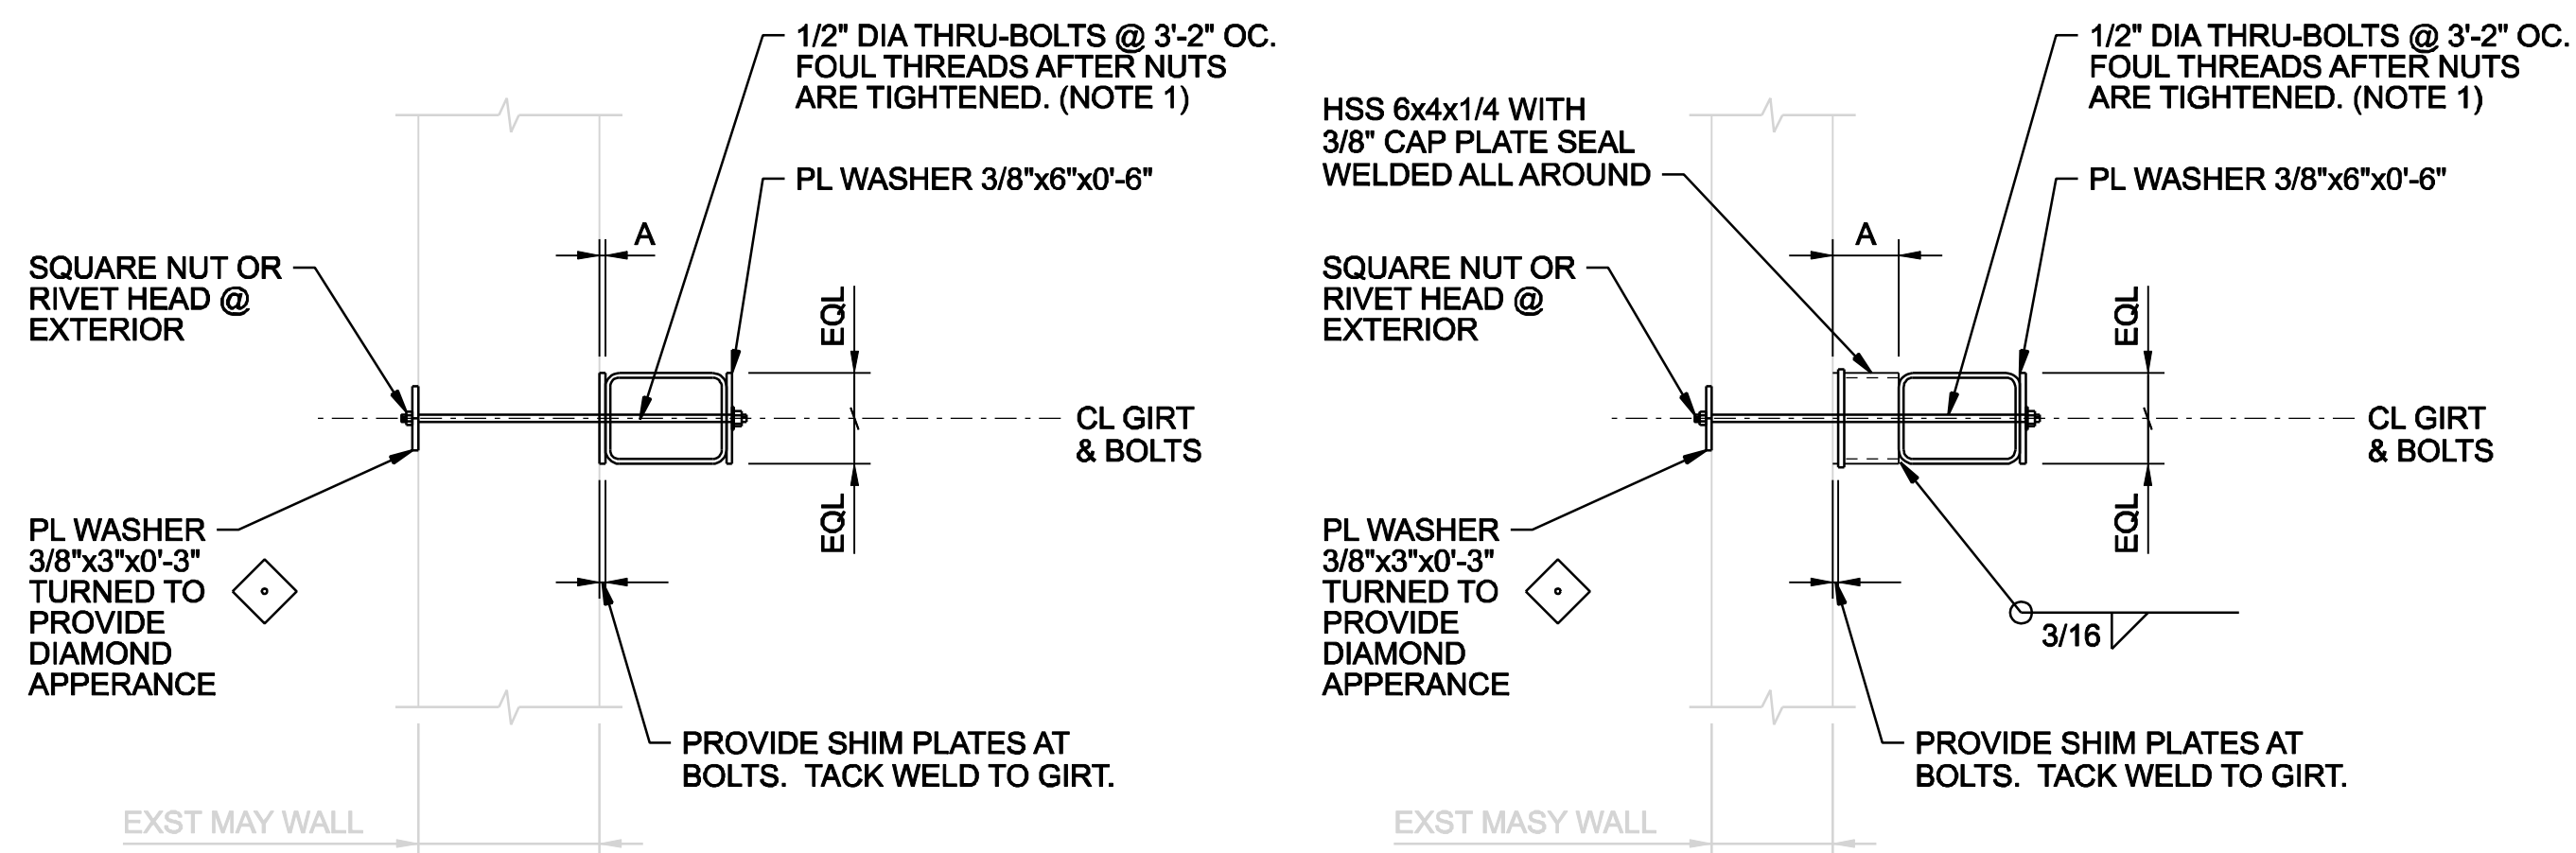


DETAIL WHERE "A"<2"
(NOTE 2)

DETAIL WHERE "A">2"
(NOTE 2)


NOTES:

1. MORTAR BOLT SOLID IN EXTERIOR WYTHE.
2. FIELD VERIFY DIMENSION 'A'

A SECTION
1"=1'-0"
S-2410, S-2411

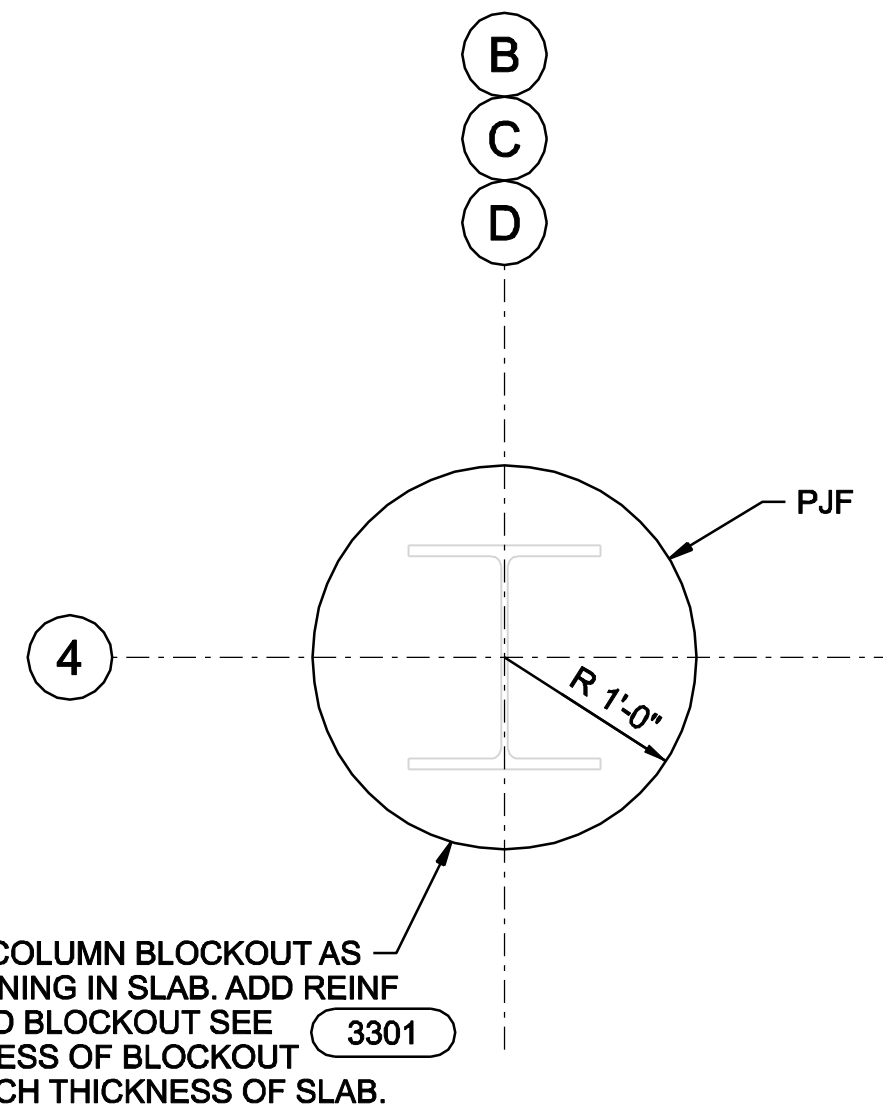

1 DETAIL
1"=1'-0"
S-2400

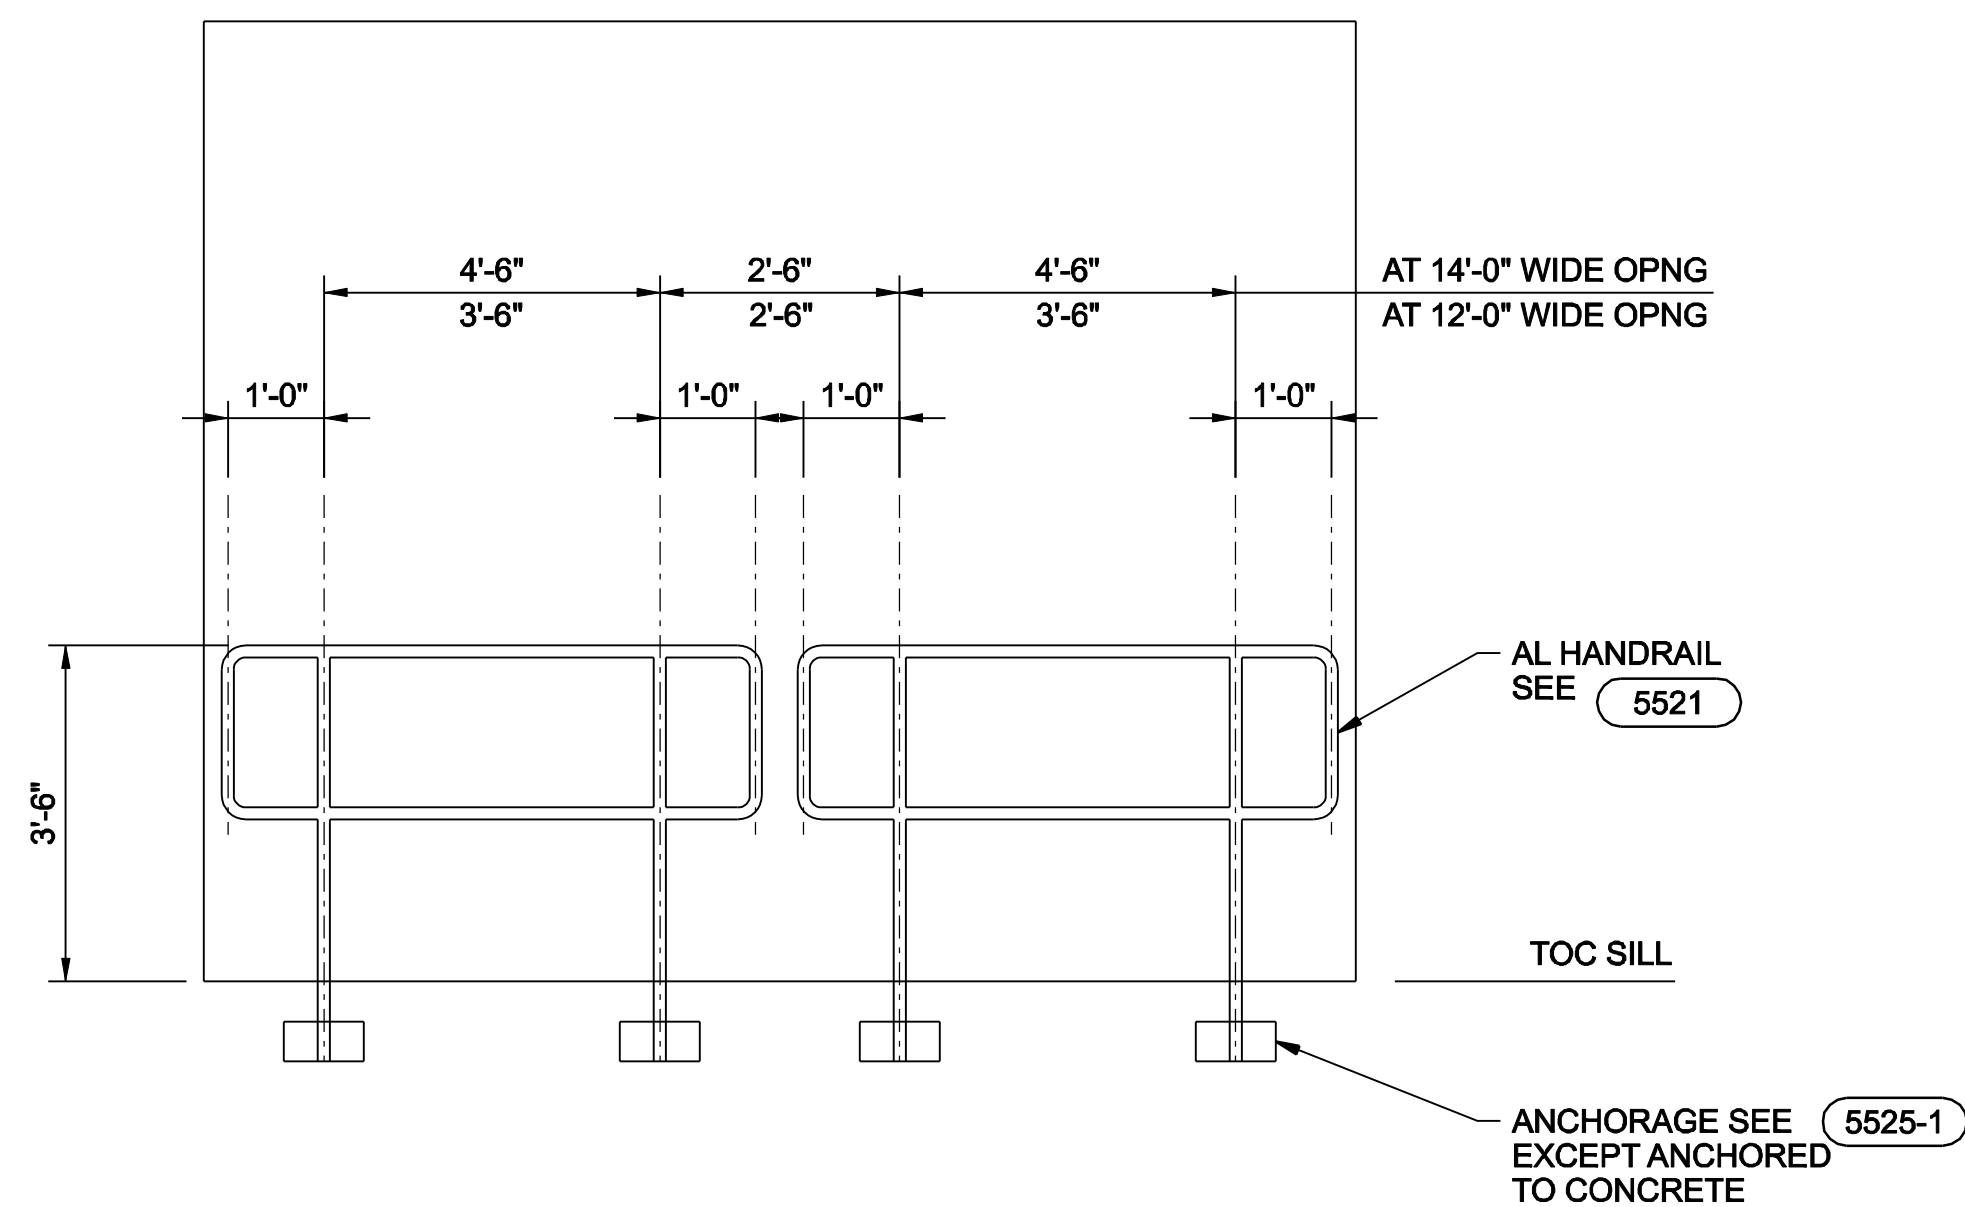

REMOVABLE ALUMINUM RAILING

2 DETAIL
1/2"=1'-0"
S-2400

THESE RECORD DOCUMENTS HAVE BEEN PREPARED BASED ON THE INFORMATION PROVIDED BY OTHERS. THE DESIGN PROFESSIONAL HAS NOT VERIFIED THE ACCURACY AND/OR COMPLETENESS OF THIS INFORMATION AND SHALL NOT BE RESPONSIBLE FOR ANY ERRORS OR OMISSIONS WHICH MAY BE INCORPORATED HEREIN AS A RESULT.



CH2MHILL

STAMFORD WATER POLLUTION CONTROL AUTHORITY
SOLIDS DRYING PROJECT

STRUCTURAL
MISCELLANEOUS DETAILS 7

VERIFY SCALE	
BAR IS ONE INCH ON ORIGINAL DRAWING.	
DATE	JUNE 2006
PROJ	334058
DWG	S-2424
SHEET	S37

RECORD DRAWING	RE-ISSUED FOR CONSTRUCTION	ISSUED FOR CONSTRUCTION	FOR FINAL REVIEW/ BUILDING PERMIT
01/20/08	09/09/06	07/04/06	06/19/06
3	2	1	0
DSGN	NO.	DATE	REVISION
M. CHEZANOWSKI			
DR	CHK	APVD	
G. OMORI	M. GOODSON	B. GACKSTATTER	
BG	BG	PW	BG
BG	BG	PW	BG
BG	BG	PW	BG
BY	APVD		