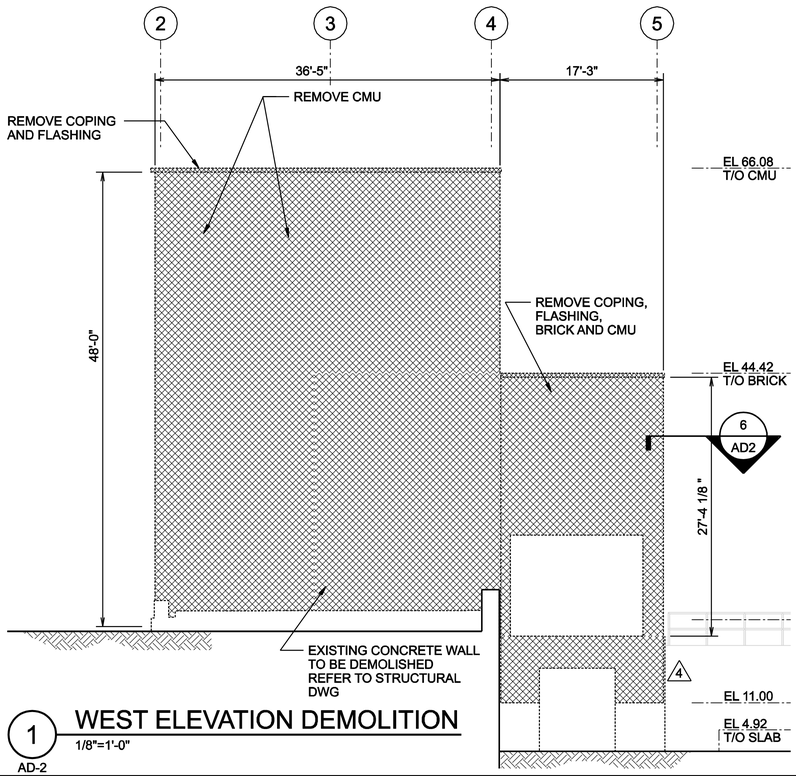

1 WEST ELEVATION DEMOLITION

1/8"=1'-0"

AD-2

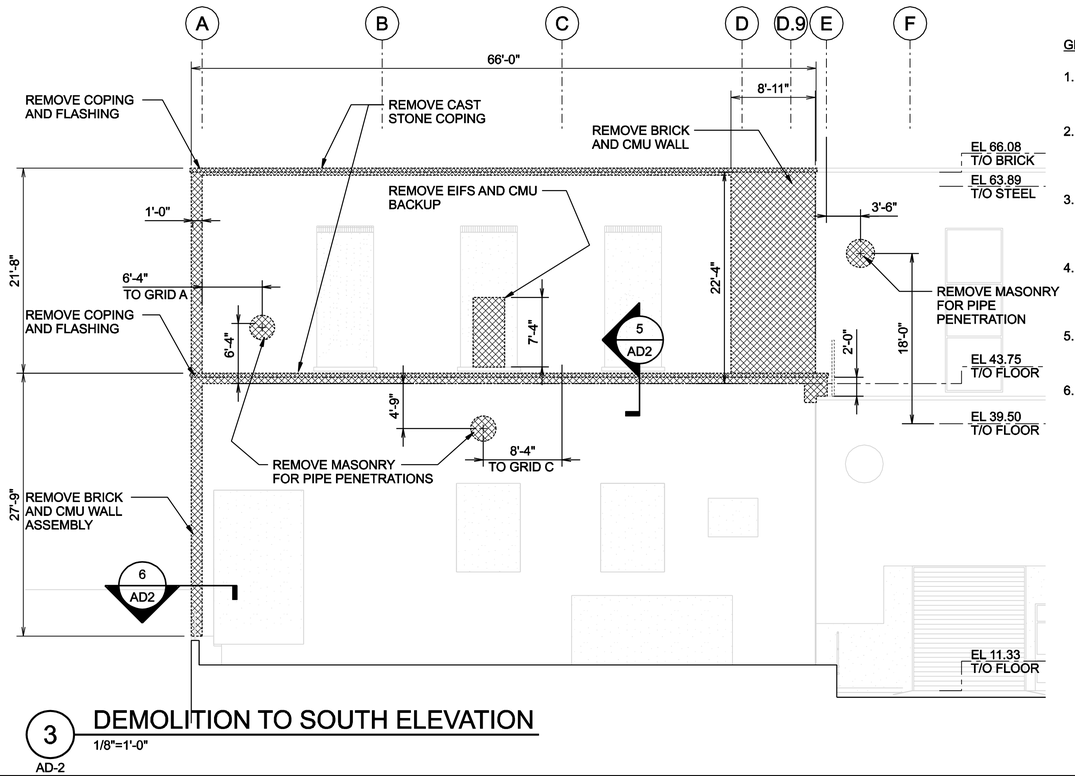

3 DEMOLITION TO SOUTH ELEVATION

1/8"=1'-0"

AD-2

GENERAL NOTES:

1. ALL DIMENSIONS ARE APPROXIMATE. VERIFY ALL DIMENSIONS AND CONDITIONS OF SITE.
2. PROTECT ADJACENT ITEMS TO REMAIN. REPAIR ALL DAMAGES TO EXISTING SURFACES INCURRED BY DEMOLITION WORK.
3. DRAWINGS TO BE READ IN CONJUNCTION WITH STRUCTURAL, BUILDING SERVICES, ELECTRICAL AND ANDRITZ DEMOLITION DRAWINGS
4. VERIFY PENETRATION SIZES THROUGH EXISTING WALL ASSEMBLY TO BUILDING SERVICES AND ANDRTIZ DRAWINGS.
5. REFER TO SPECIFICATIONS FOR CLEANING AND PREPARATION OF EXISTING SURFACES.
6. REFER TO STRUCTURAL DRAWINGS FOR FULL DETAILS OF CONCRETE AND CMU DEMOLITION.

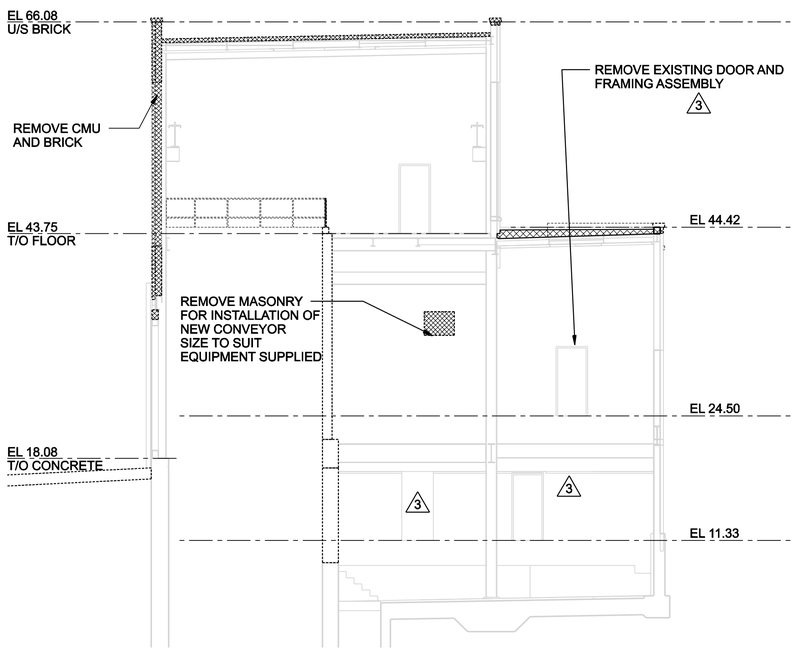

3 BUILDING SECTION

NTS

AD-1

THESE RECORD DOCUMENTS HAVE BEEN PREPARED BASED ON THE INFORMATION PROVIDED BY OTHERS. THE DESIGN PROFESSIONAL HAS NOT VERIFIED THE ACCURACY AND/OR COMPLETENESS OF THIS INFORMATION AND SHALL NOT BE RESPONSIBLE FOR ANY ERRORS OR OMISSIONS WHICH MAY BE INCORPORATED HEREIN AS A RESULT.

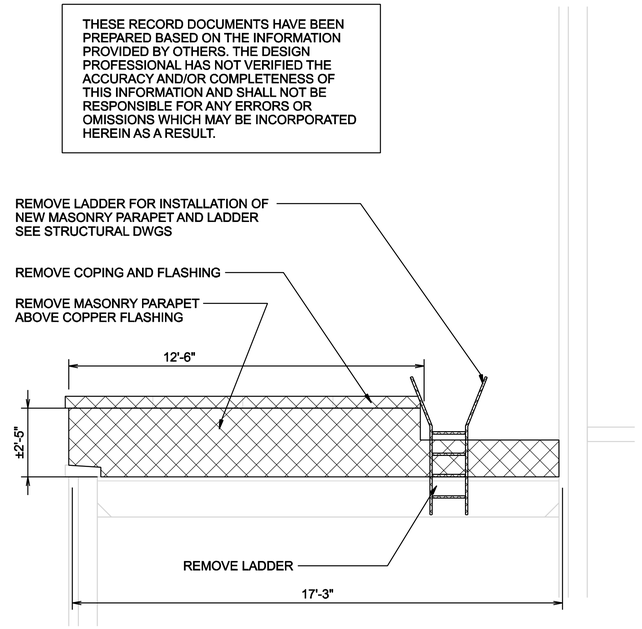

4 EAST ELEVATION - SOUTH ROOF

3/8"=1'-0"

AD-1

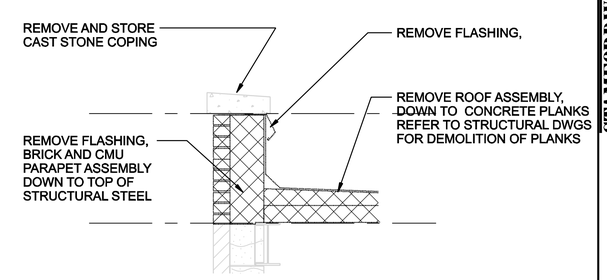

5 PARAPET DEMOLITION DETAIL

NTS

AD-2

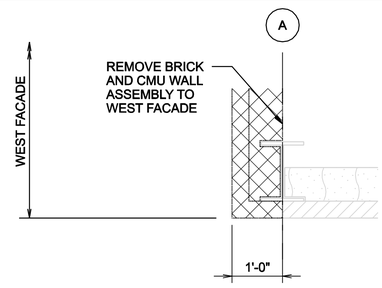

6 CORNER DEMOLITION PLAN

NTS

AD-2

NO.	DATE	DR	CHK	REVISION
5	01/20/08	W YU	W YU	RECORD DRAWING
4	01/29/07			REVISION PER CCIR No.DR-12
3	10/16/07			REVISION PER CCIR No.DR-2
2	09/08/06			RE-ISSUED FOR CONSTRUCTION
1	07/04/06			ISSUED FOR CONSTRUCTION
0	06/05/06			FOR FINAL REVIEW/ BUILDING PERMIT
DSGN		BG	L GRANDE	APVD
		BG	B. GACKSTATTER	BY
			PW	APVD
		BG	PW	
		LG	BG	

©CH2M HILL 2004. ALL RIGHTS RESERVED.
REUSE OF DOCUMENTS: THIS DOCUMENT, AND THE IDEAS AND DESIGNS INCORPORATED HEREIN, AS AN INSTRUMENT OF PROFESSIONAL SERVICE, IS THE PROPERTY OF CH2M HILL AND IS NOT TO BE USED, IN WHOLE OR IN PART, FOR ANY OTHER PROJECT WITHOUT THE WRITTEN AUTHORIZATION OF CH2MHILL.

STAMFORD WPCA

STAMFORD WATER POLLUTION CONTROL AUTHORITY
SOLIDS DRYING PROJECT

CH2MHILL

ARCHITECTURAL
DEMOLITION PLANS

VERIFY SCALE

BAR IS ONE INCH ON ORIGINAL DRAWING.
0 1"

DATE	JUNE 2006
PROJ	334058
DWG	AD-2
SHEET	A2

FILENAME: std002_334058.dgn MODIFIED DATE: MODIFIED TIME: