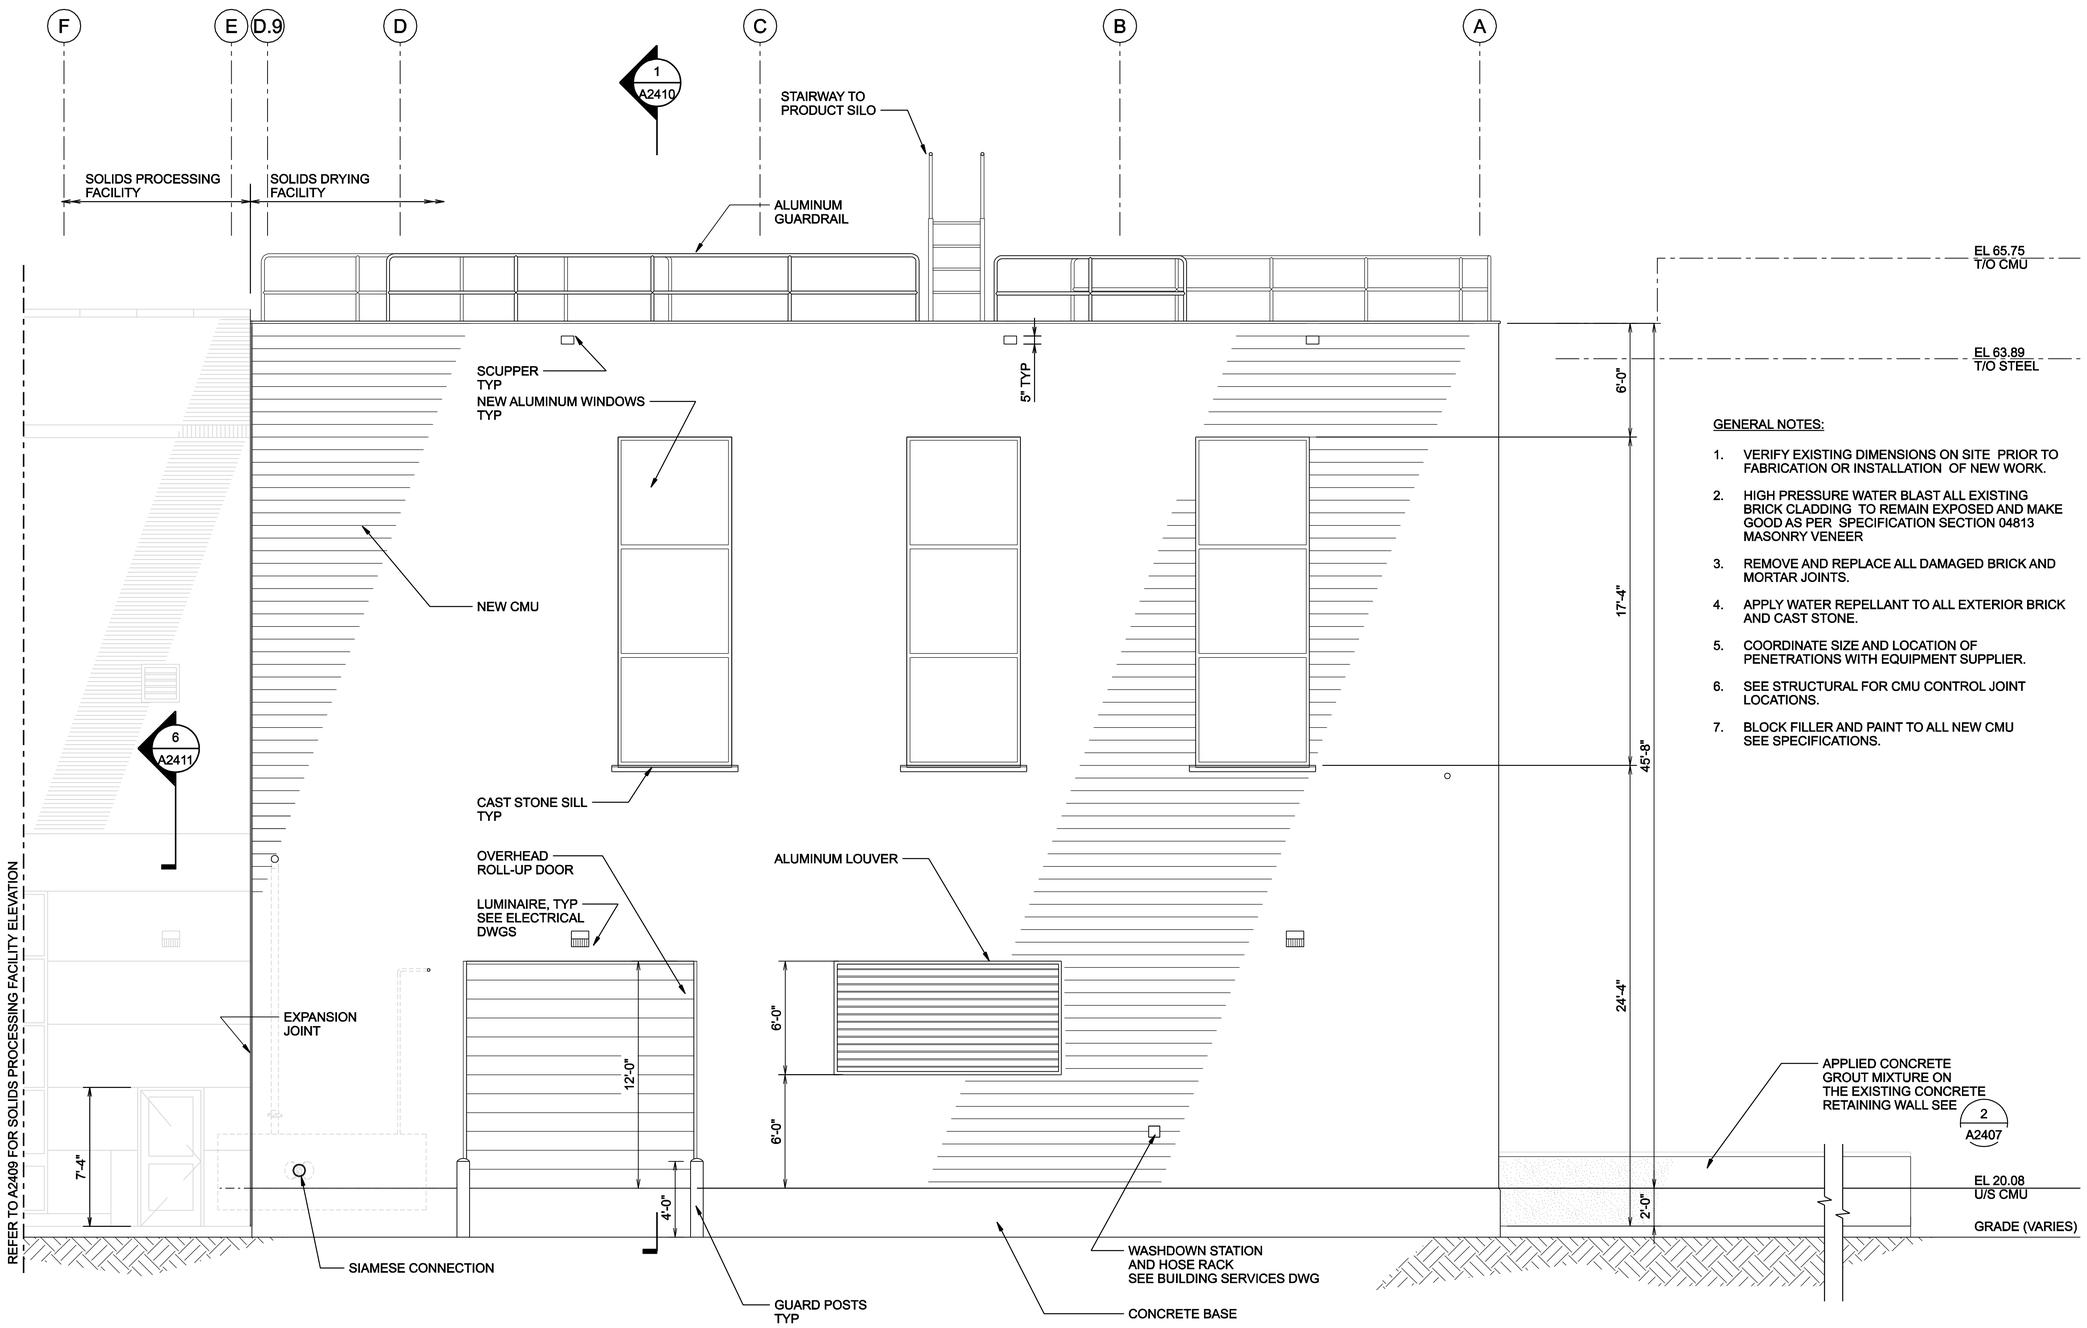

GENERAL NOTES:

1. VERIFY EXISTING DIMENSIONS ON SITE PRIOR TO FABRICATION OR INSTALLATION OF NEW WORK.
2. HIGH PRESSURE WATER BLAST ALL EXISTING BRICK CLADDING TO REMAIN EXPOSED AND MAKE GOOD AS PER SPECIFICATION SECTION 04813 MASONRY VENEER
3. REMOVE AND REPLACE ALL DAMAGED BRICK AND MORTAR JOINTS.
4. APPLY WATER REPELLANT TO ALL EXTERIOR BRICK AND CAST STONE.
5. COORDINATE SIZE AND LOCATION OF PENETRATIONS WITH EQUIPMENT SUPPLIER.
6. SEE STRUCTURAL FOR CMU CONTROL JOINT LOCATIONS.
7. BLOCK FILLER AND PAINT TO ALL NEW CMU SEE SPECIFICATIONS.

1 NORTH ELEVATION
A2406
1/4"=1'-0"

THESE RECORD DOCUMENTS HAVE BEEN PREPARED BASED ON THE INFORMATION PROVIDED BY OTHERS. THE DESIGN PROFESSIONAL HAS NOT VERIFIED THE ACCURACY AND/OR COMPLETENESS OF THIS INFORMATION AND SHALL NOT BE RESPONSIBLE FOR ANY ERRORS OR OMISSIONS WHICH MAY BE INCORPORATED HEREIN AS A RESULT.

NO.	DATE	DR	CHK	REVISION	BY	APVD
3	01/20/08	W YU	W YU	RECORD DRAWING	BG	BG
2	09/08/06			RE-ISSUED FOR CONSTRUCTION	BG	PW
1	07/04/06			ISSUED FOR CONSTRUCTION	BG	PW
0	06/05/06			FOR FINAL REVIEW/ BUILDING PERMIT	LG	BG
DSGN		W YU	L GRANDE	APVD B GACKSTATTER		

STAMFORD WATER POLLUTION CONTROL AUTHORITY
SOLIDS DRYING PROJECT

CH2MHILL

ARCHITECTURAL
NORTH ELEVATION

VERIFY SCALE
BAR IS ONE INCH ON ORIGINAL DRAWING.
0 1"

DATE	JUNE 2006
PROJ	334058
DWG	A-2406
SHEET	A9

REUSE OF DOCUMENTS: THIS DOCUMENT, AND THE IDEAS AND DESIGNS INCORPORATED HEREIN, AS AN INSTRUMENT OF PROFESSIONAL SERVICE, IS THE PROPERTY OF CH2M HILL AND IS NOT TO BE USED, IN WHOLE OR IN PART, FOR ANY OTHER PROJECT WITHOUT THE WRITTEN AUTHORIZATION OF CH2MHILL.
© CH2M HILL 2004. ALL RIGHTS RESERVED.

FILENAME: sta2406_334058.dgn MODIFIED DATE: MODIFIED TIME: