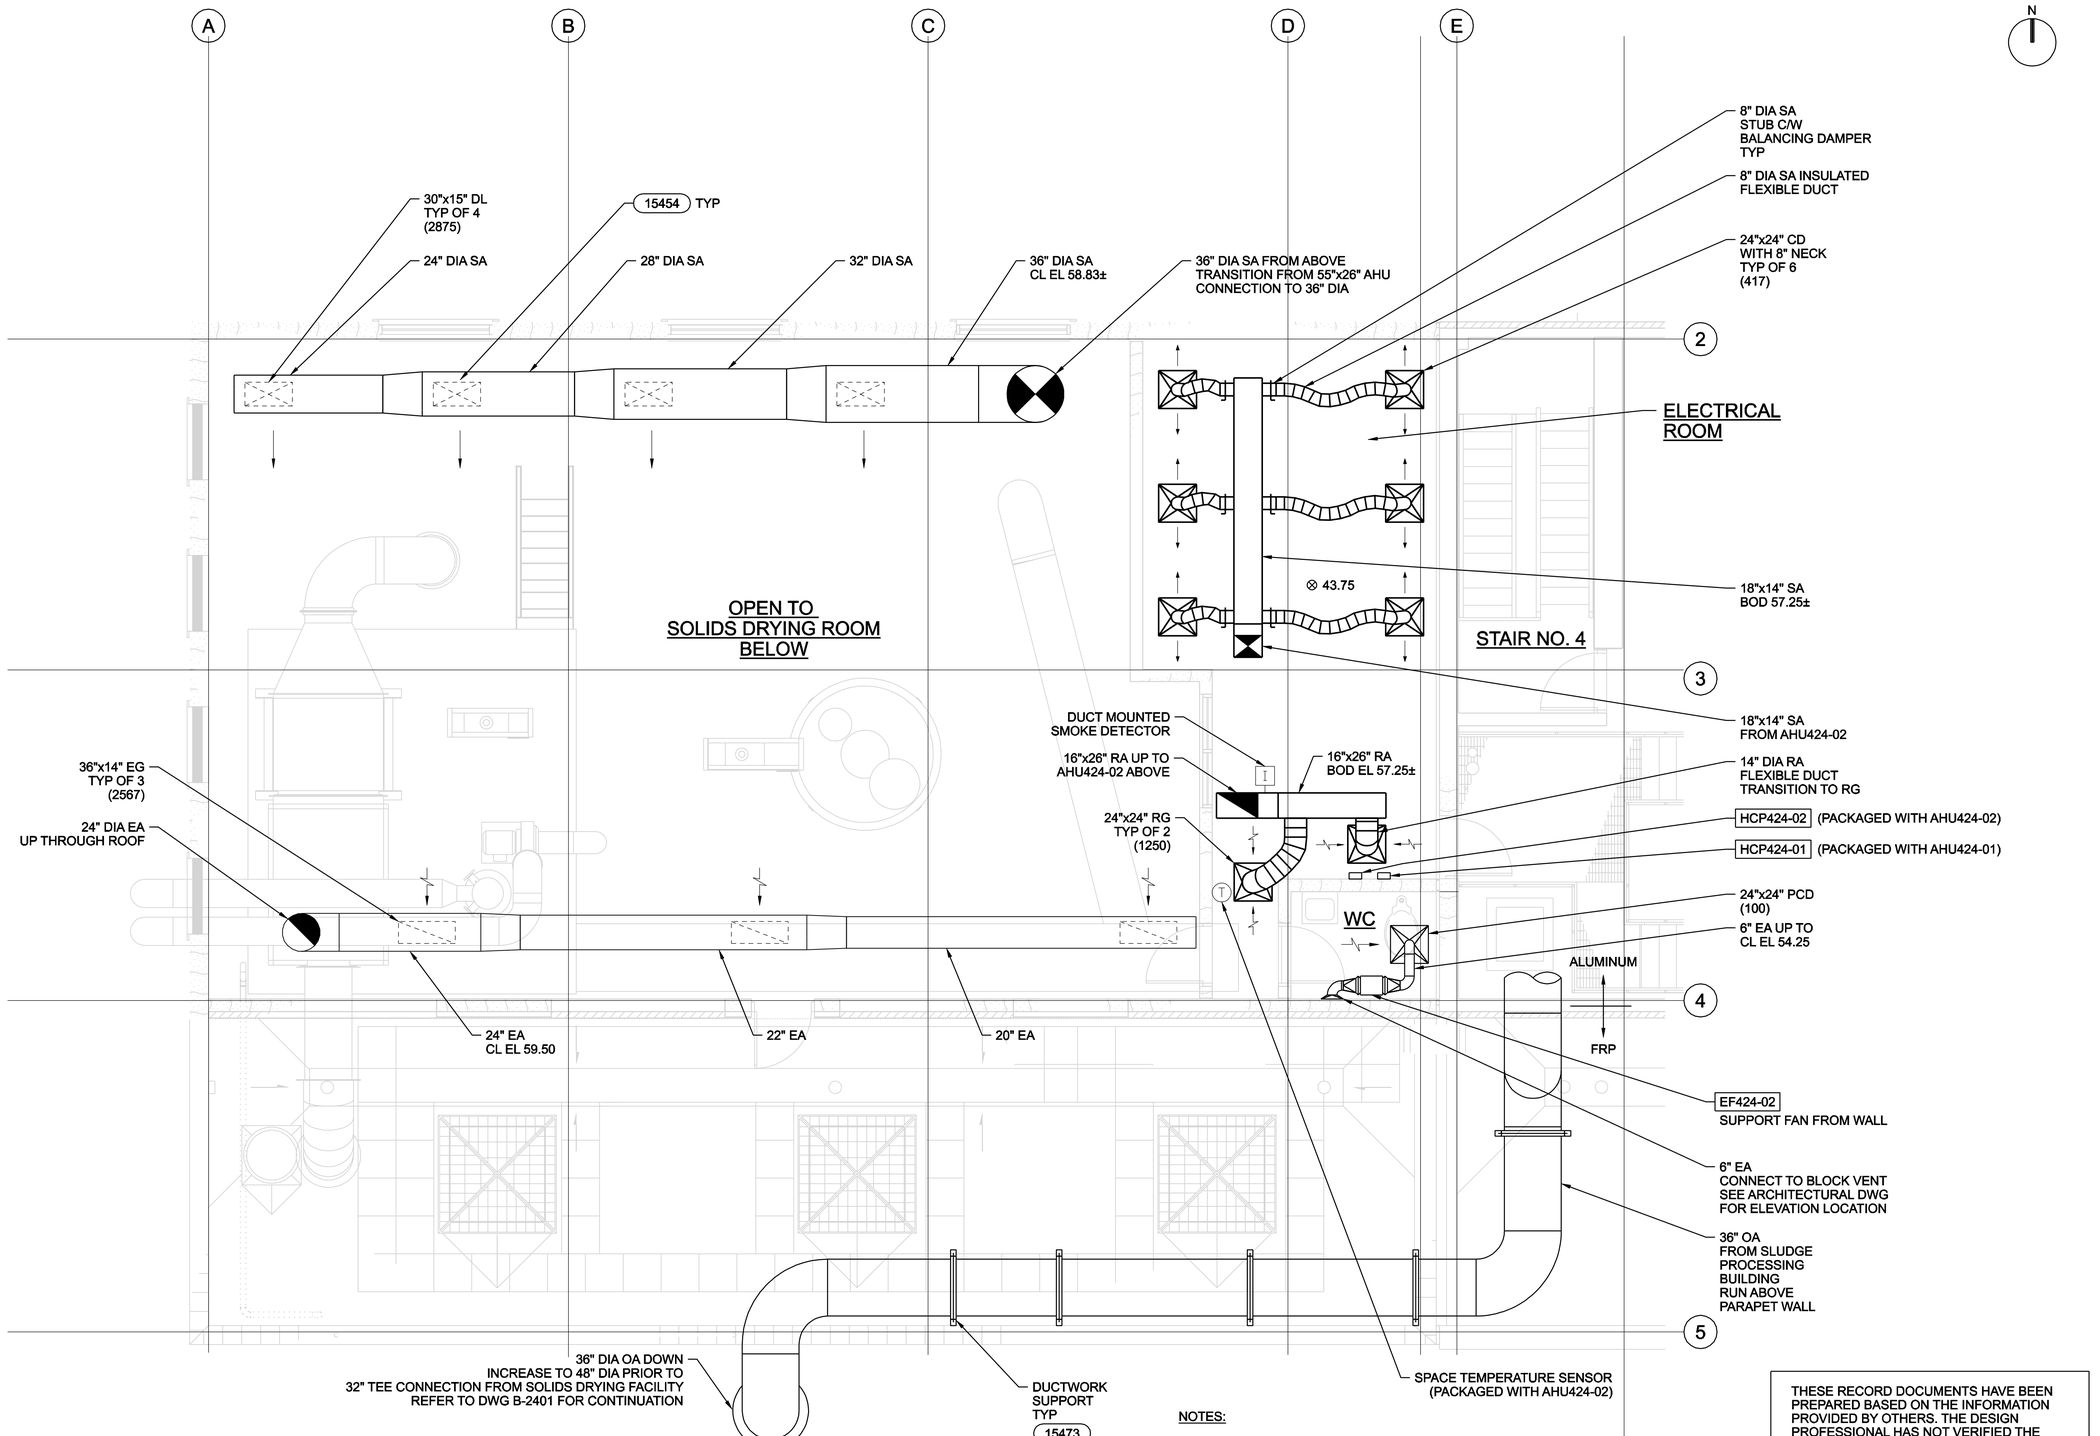

1 THIRD FLOOR PLAN

1/4"=1'-0"

NOTES:

1. DRYER EQUIPMENT AND PLATFORMS PROVIDED BY ANDRITZ ARE SHOWN FOR REFERENCE ONLY. REFER TO ANDRITZ DRAWINGS FOR EXACT LOCATION AND ELEVATION OF EQUIPMENT.
2. ALL DUCTWORK FOR HVAC SYSTEMS TO GALVANIZED STEEL.

THESE RECORD DOCUMENTS HAVE BEEN PREPARED BASED ON THE INFORMATION PROVIDED BY OTHERS. THE DESIGN PROFESSIONAL HAS NOT VERIFIED THE ACCURACY AND/OR COMPLETENESS OF THIS INFORMATION AND SHALL NOT BE RESPONSIBLE FOR ANY ERRORS OR OMISSIONS WHICH MAY BE INCORPORATED HEREIN AS A RESULT.

NO.	DATE	REVISION	BY	APVD
3	01/20/08	RECORD DRAWING	BG	BG
2	09/08/06	RE-ISSUED FOR CONSTRUCTION	BG	PW
1	07/04/06	ISSUED FOR CONSTRUCTION	BG	PW
0	06/05/06	FOR FINAL REVIEW/ BUILDING PERMIT	MR	BG

DSGN S LAROCQUE DR S LAROCQUE CHK M RAHMAN APVD B GACKSTATTER

STAMFORD WATER POLLUTION CONTROL AUTHORITY
SOLIDS DRYING PROJECT

CH2MHILL

BUILDING SERVICES
HVAC
THIRD FLOOR PLAN

VERIFY SCALE
BAR IS ONE INCH ON ORIGINAL DRAWING.
0 1"

DATE	JUNE 2006
PROJ	334058
DWG	B-2402
SHEET	B4

REUSE OF DOCUMENTS: THIS DOCUMENT, AND THE IDEAS AND DESIGNS INCORPORATED HEREIN, AS AN INSTRUMENT OF PROFESSIONAL SERVICE, IS THE PROPERTY OF CH2M HILL AND IS NOT TO BE USED, IN WHOLE OR IN PART, FOR ANY OTHER PROJECT WITHOUT THE WRITTEN AUTHORIZATION OF CH2MHILL.
© CH2M HILL 2004. ALL RIGHTS RESERVED.

FILENAME: stb2402,334058.dgn MODIFIED DATE: MODIFIED TIME: